


**NOTES:**  
 CONTRACTORS MUST VERIFY ALL LEVELS AND DIMENSIONS ON SITE BEFORE COMMENCING WORK OR MAKING ANY SHOP DRAWINGS. NOTIFY ARCHITECTS OF ANY DISCREPANCIES BEFORE PROCEEDING. THIS DRAWING TO BE READ IN CONJUNCTION WITH FINISHES SCHEDULE AND SPECIFICATION. THIS DRAWING IS COPYRIGHT AND REMAINS THE PROPERTY OF THE ARCHITECT.

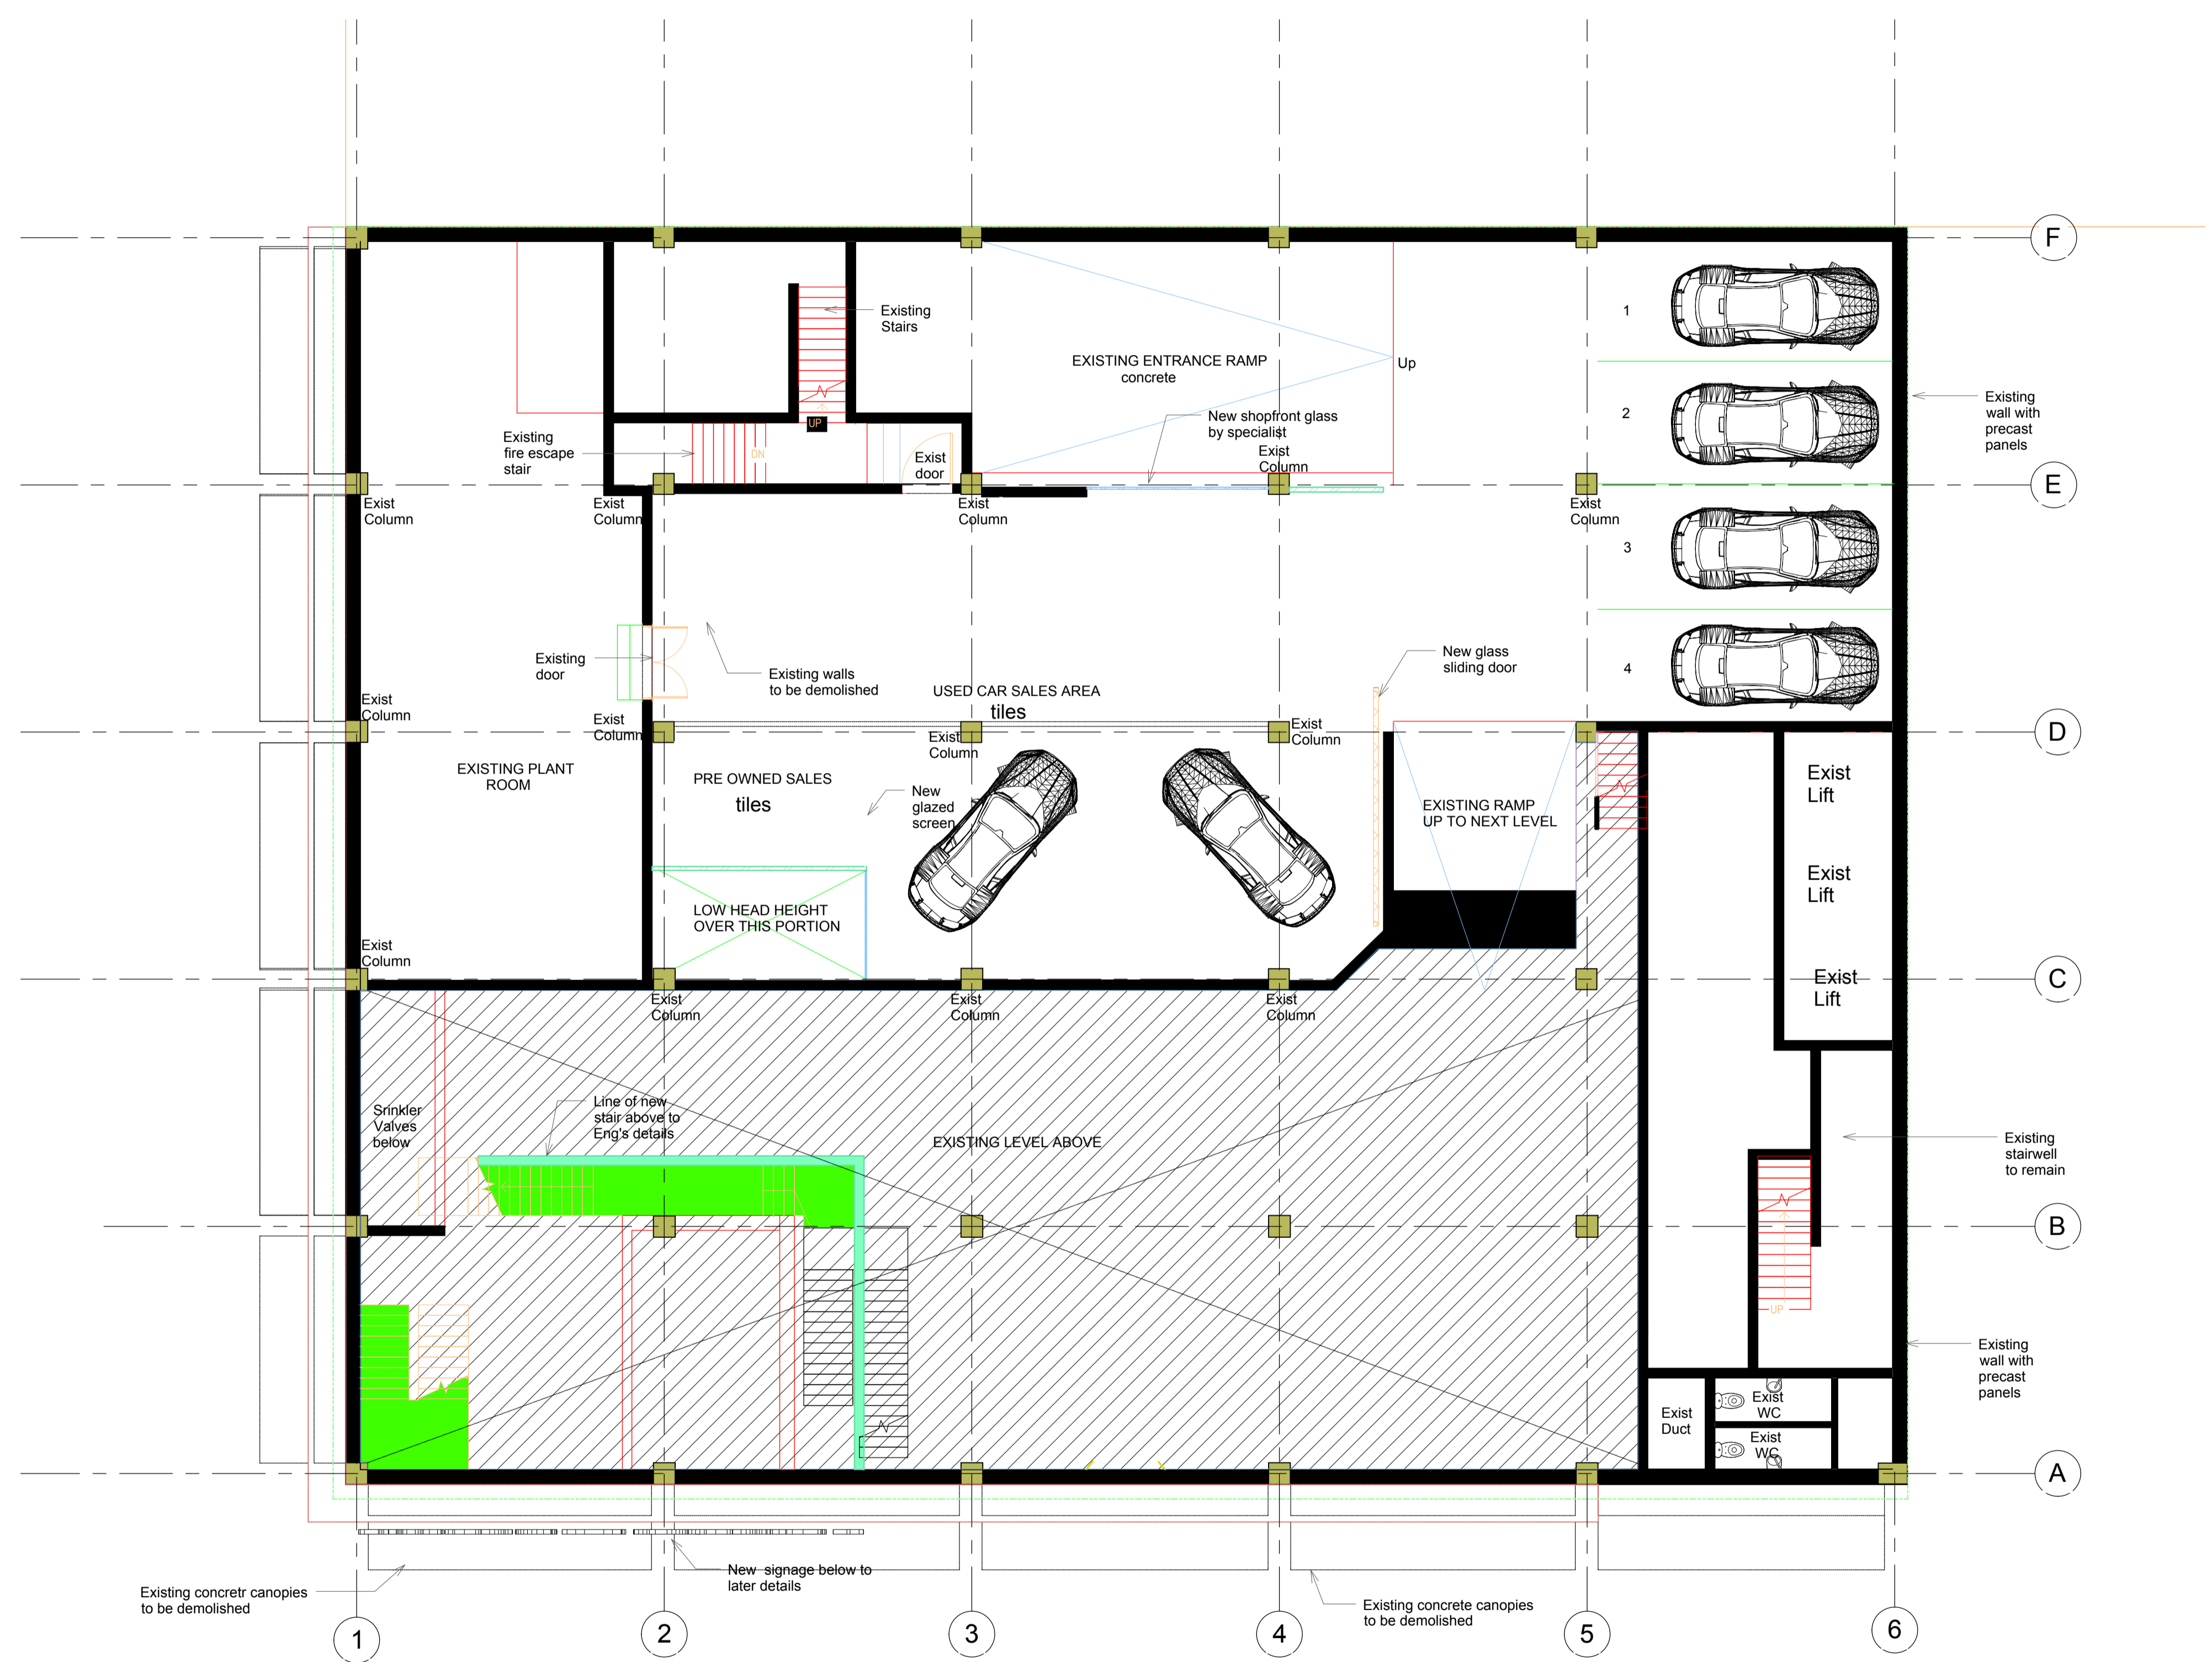

**00B LEVEL PLAN**

Client Signature  
 \_\_\_\_\_  
 Architect Signature  
 \_\_\_\_\_

REV.	DATE	DESCRIPTION
REVISIONS		

**kotlowitz marais architects**  
T: (21) 465 5728 F: (21) 465 7192 A: info@kma.co.za  
 68 ROLAND STREET, CNR OF ROLAND & CONTEMPORARY STREET  
 VREDEHEK, CAPE TOWN

PROJECT:  
**PROPOSED ALTERATIONS TO EXISTING BUILDING**  
 FOR:  
**MASERATI**  
 ERF: ERF 25  
 ADDRESS: CNR OF CHRISTIAN BARNARD & LOUIS GRADNER STREET CAPE TOWN

**01 LEVEL**

ISSUED FOR: AS-BUILTS

SCALE: 1 : 100 @ A1 REVISION No:

DRAWING No: 01-DW-412-110

PROJECT No: 1527 CHECKED BY: Checker