


NOTES:
 CONTRACTORS MUST VERIFY ALL LEVELS AND DIMENSIONS ON SITE BEFORE COMMENCING WORK OR MAKING ANY SHOP DRAWINGS. NOTIFY ARCHITECTS OF ANY DISCREPANCIES BEFORE PROCEEDING. THIS DRAWING TO BE READ IN CONJUNCTION WITH FINISHES SCHEDULE AND SPECIFICATION. THIS DRAWING IS COPYRIGHT AND REMAINS THE PROPERTY OF THE ARCHITECT.

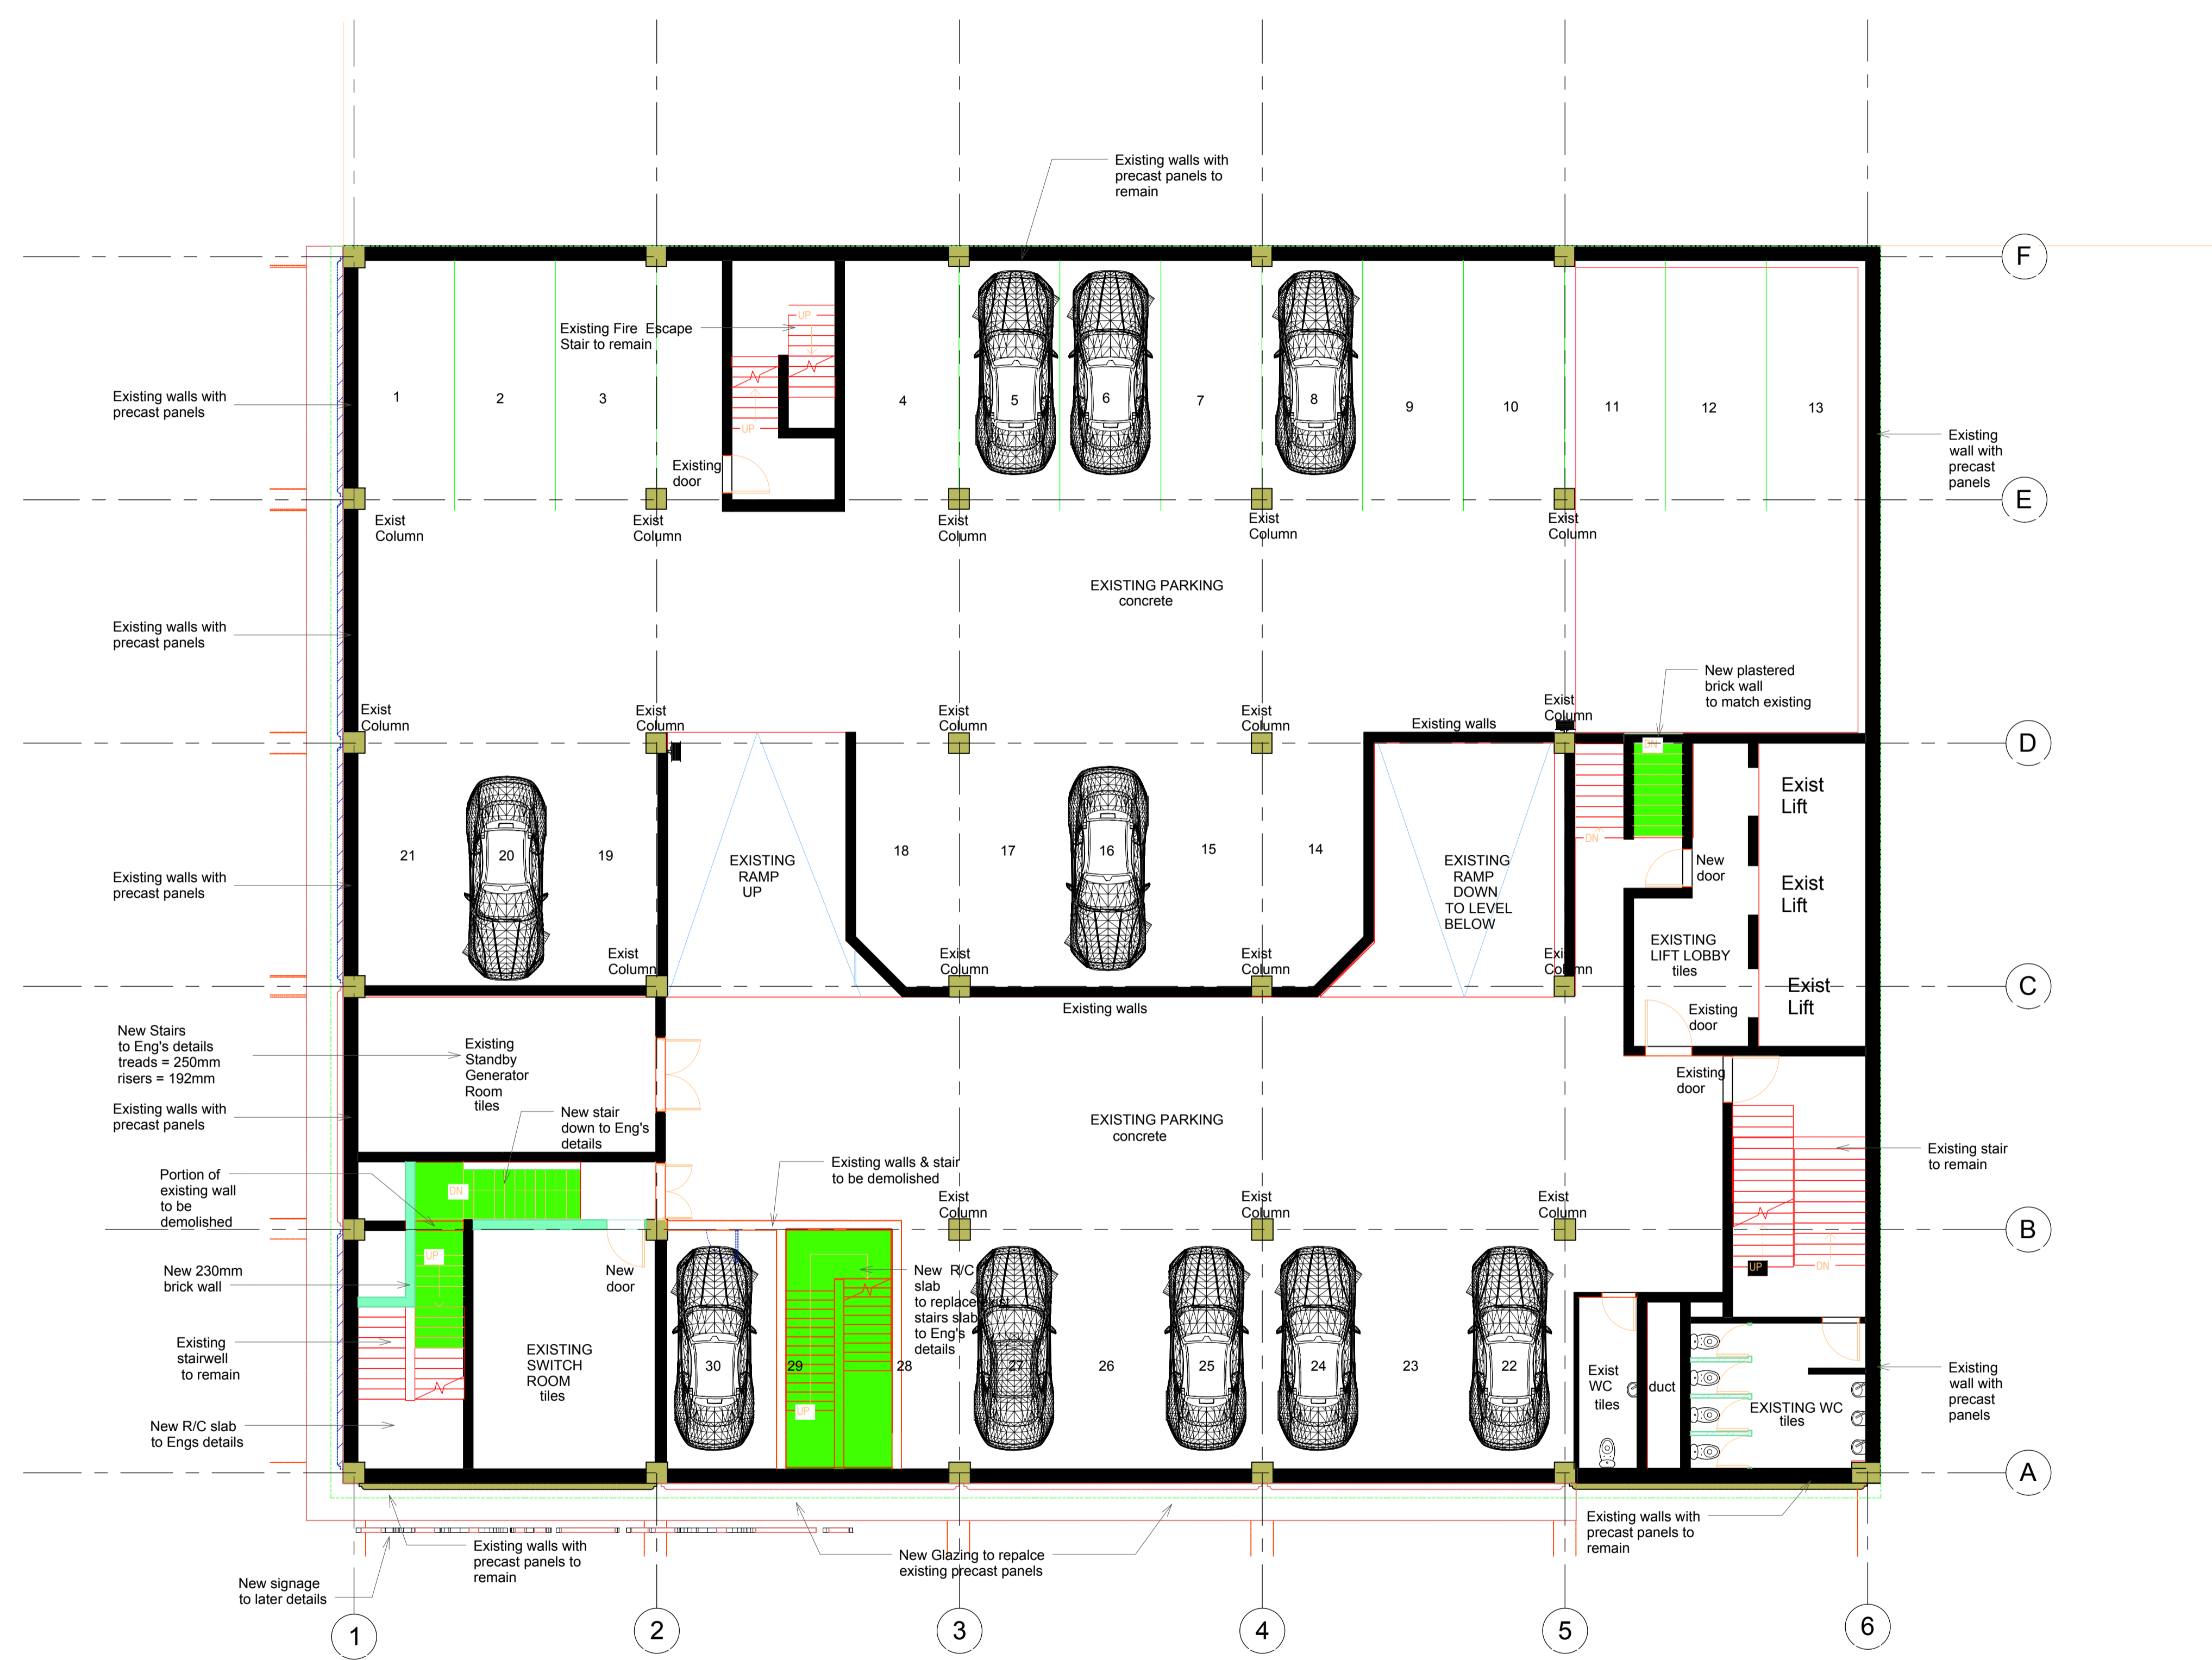

01A LEVEL PLAN

Client Signature
 Architect Signature

REV.	DATE	DESCRIPTION
REVISIONS		

km
kotlowitz marais architects
 T: (021) 465 5728 F: (021) 465 7792 A: info@kma.co.za
 48 ROSKILL STREET, CNR OF ROSKILL & CONTEMPORARY STREET, VREDEHOF, CAPE TOWN

PROJECT:
PROPOSED ALTERATIONS TO EXISTING BUILDING

FOR:
MASERATI

ERF: ERF 25
 ADDRESS: CNR OF CHRISTIAN BARNARD & LOUIS GRADNER STREET CAPE TOWN

02 & 2A LEVEL

ISSUED FOR:	AS-BUILTS
SCALE:	1 : 100 @ A1
DRAWING No:	01-DW-412-112
PROJECT No:	1527
CHECKED BY:	Checker