



REVISION:
 REV 0: 31/07/13
 0.1- Submitted to client

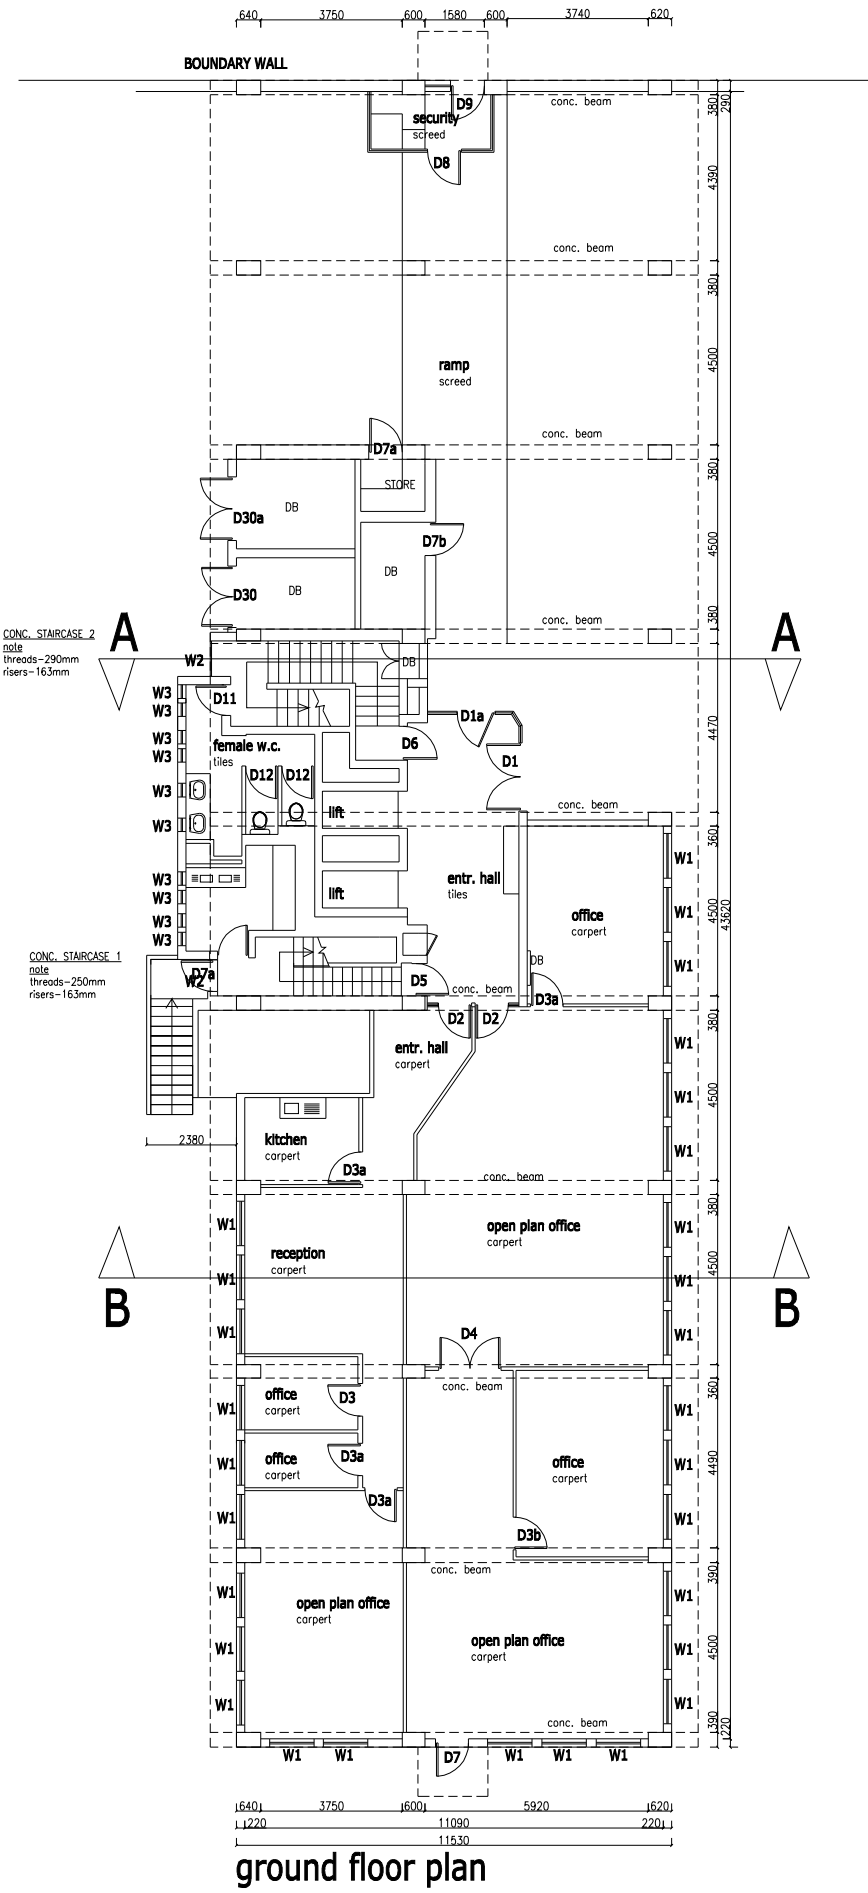



SCALE 1:200

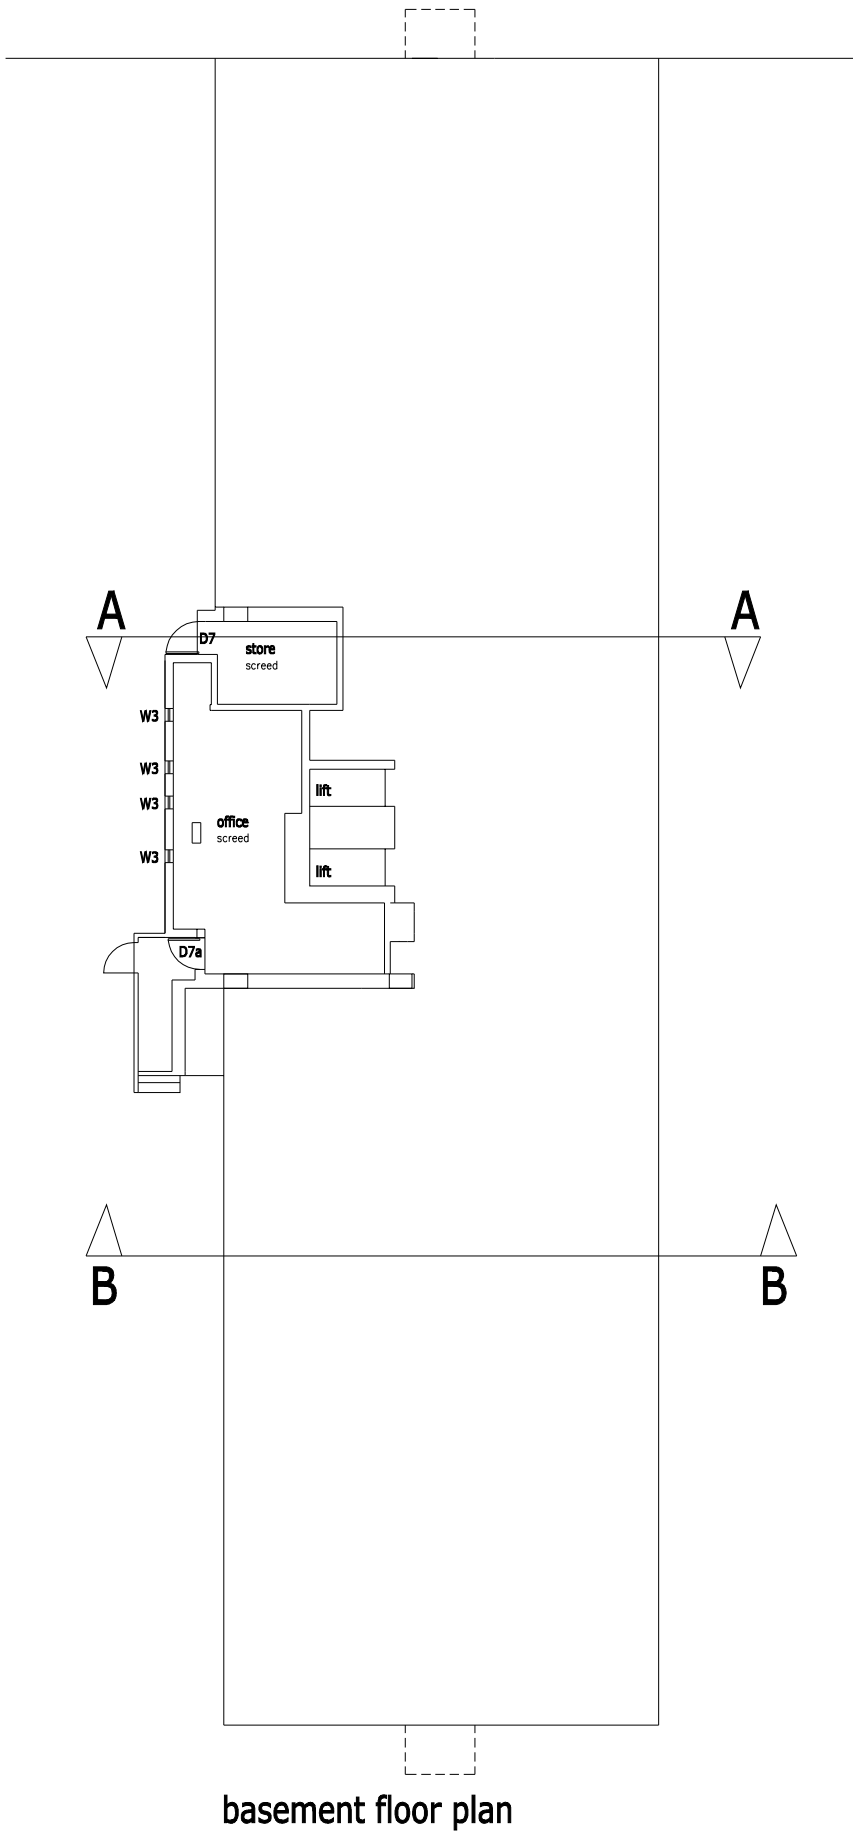

CHARTER HOUSE: Upgrade of Office Block

Dwg. ref.	Building ref.	Sheet Number	REV
AB	As-built	1 of 7	0

REVISION:
 REV 0: 31/07/13
 0.1 - Submitted to client

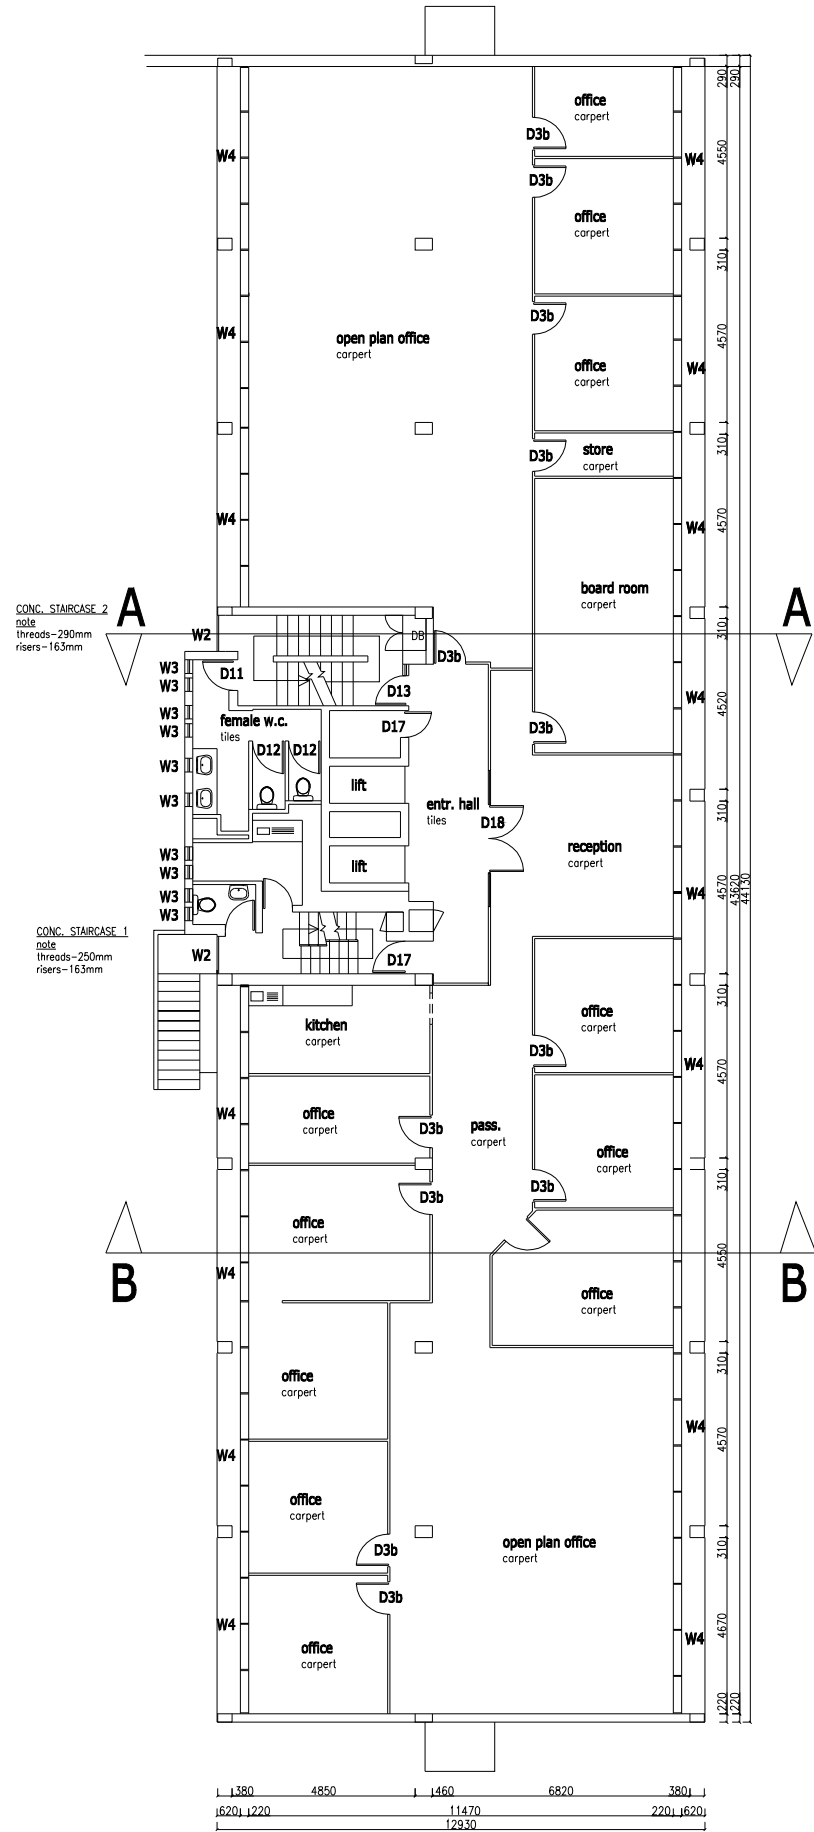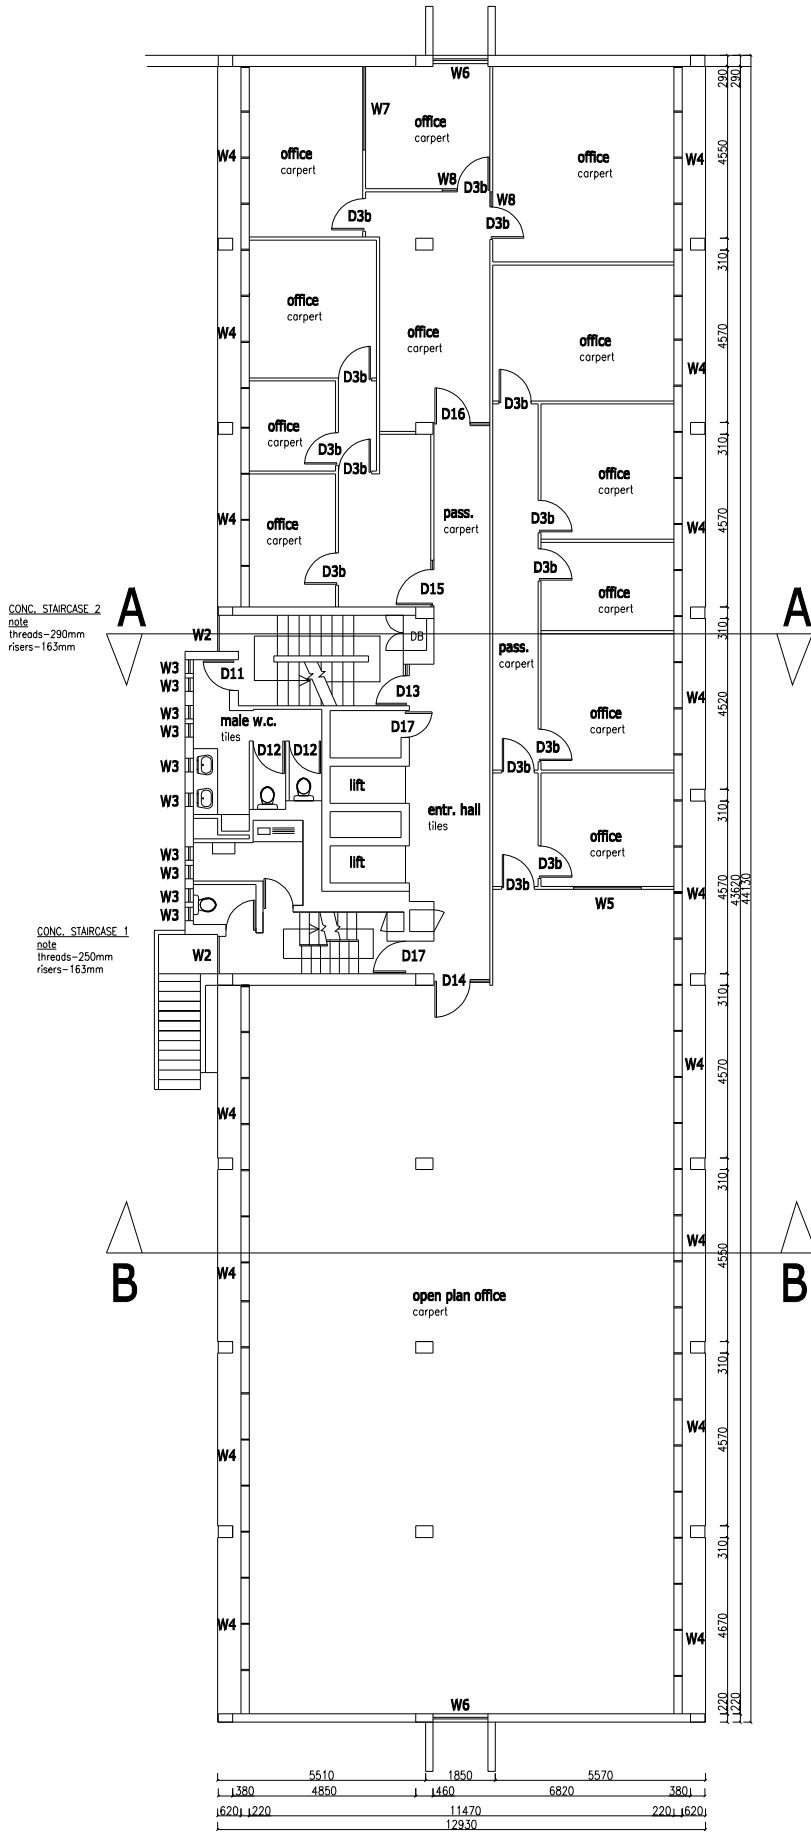

SCALE 1:200




CHARTER HOUSE: Upgrade of Office Block


15 Brand Road, Bulwer, Durban, KZN

Dwg. ref.	Building ref.	Sheet Number	REV
AB	As-built	2 of 7	0

REVISION:
 REV 0: 31/07/13
 0.1 - Submitted to client

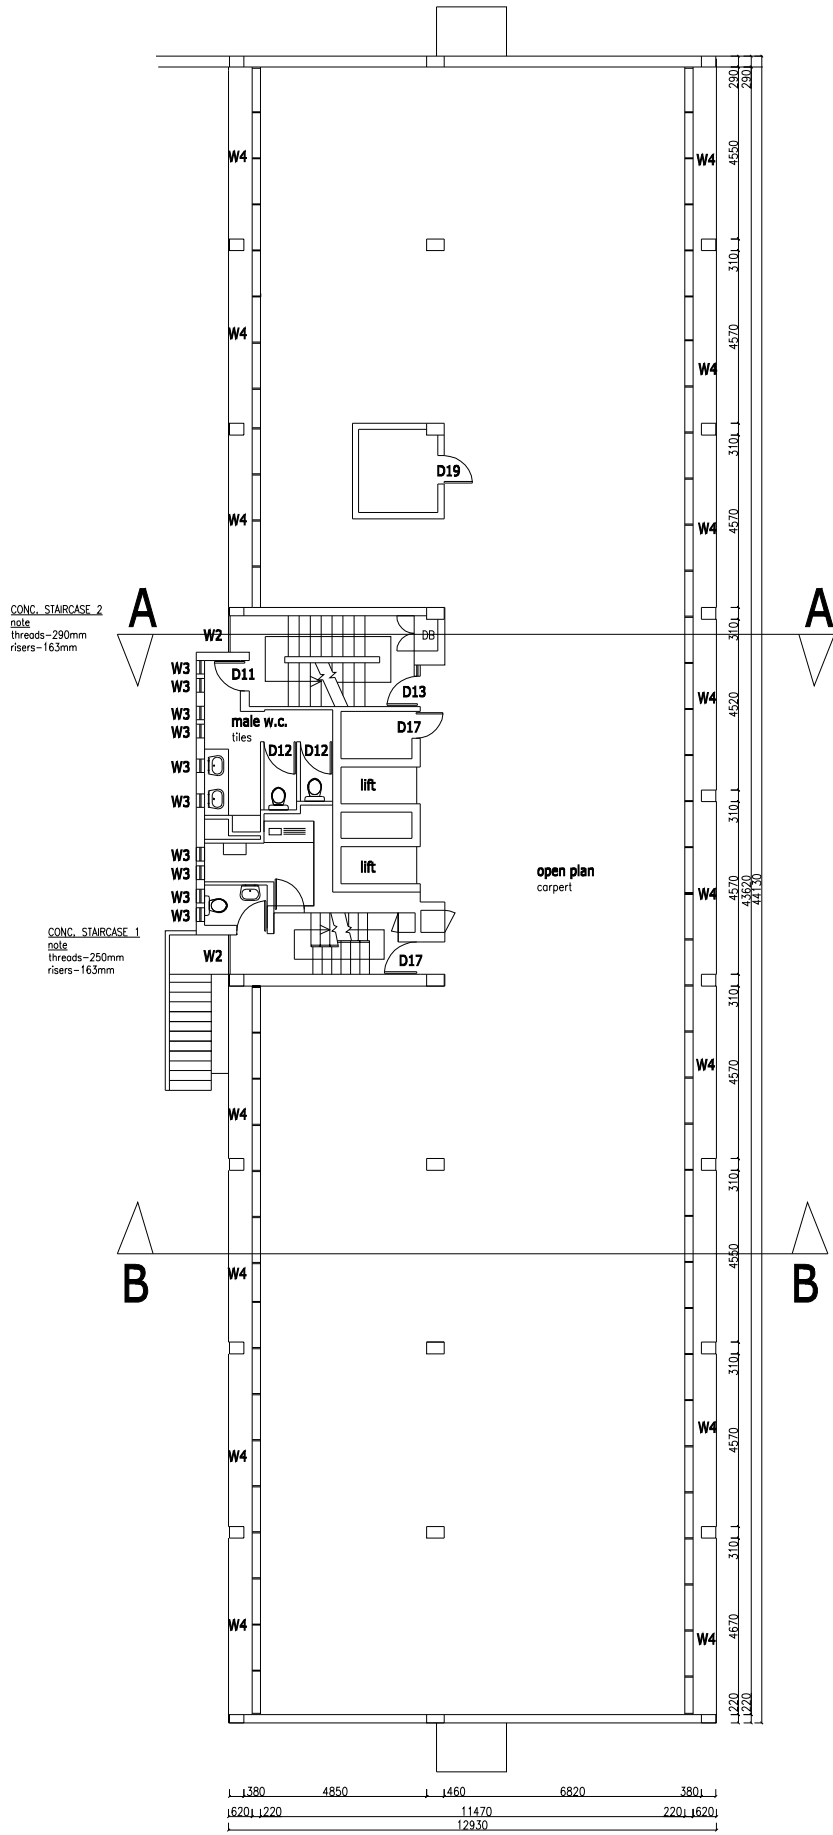

3th floor plan

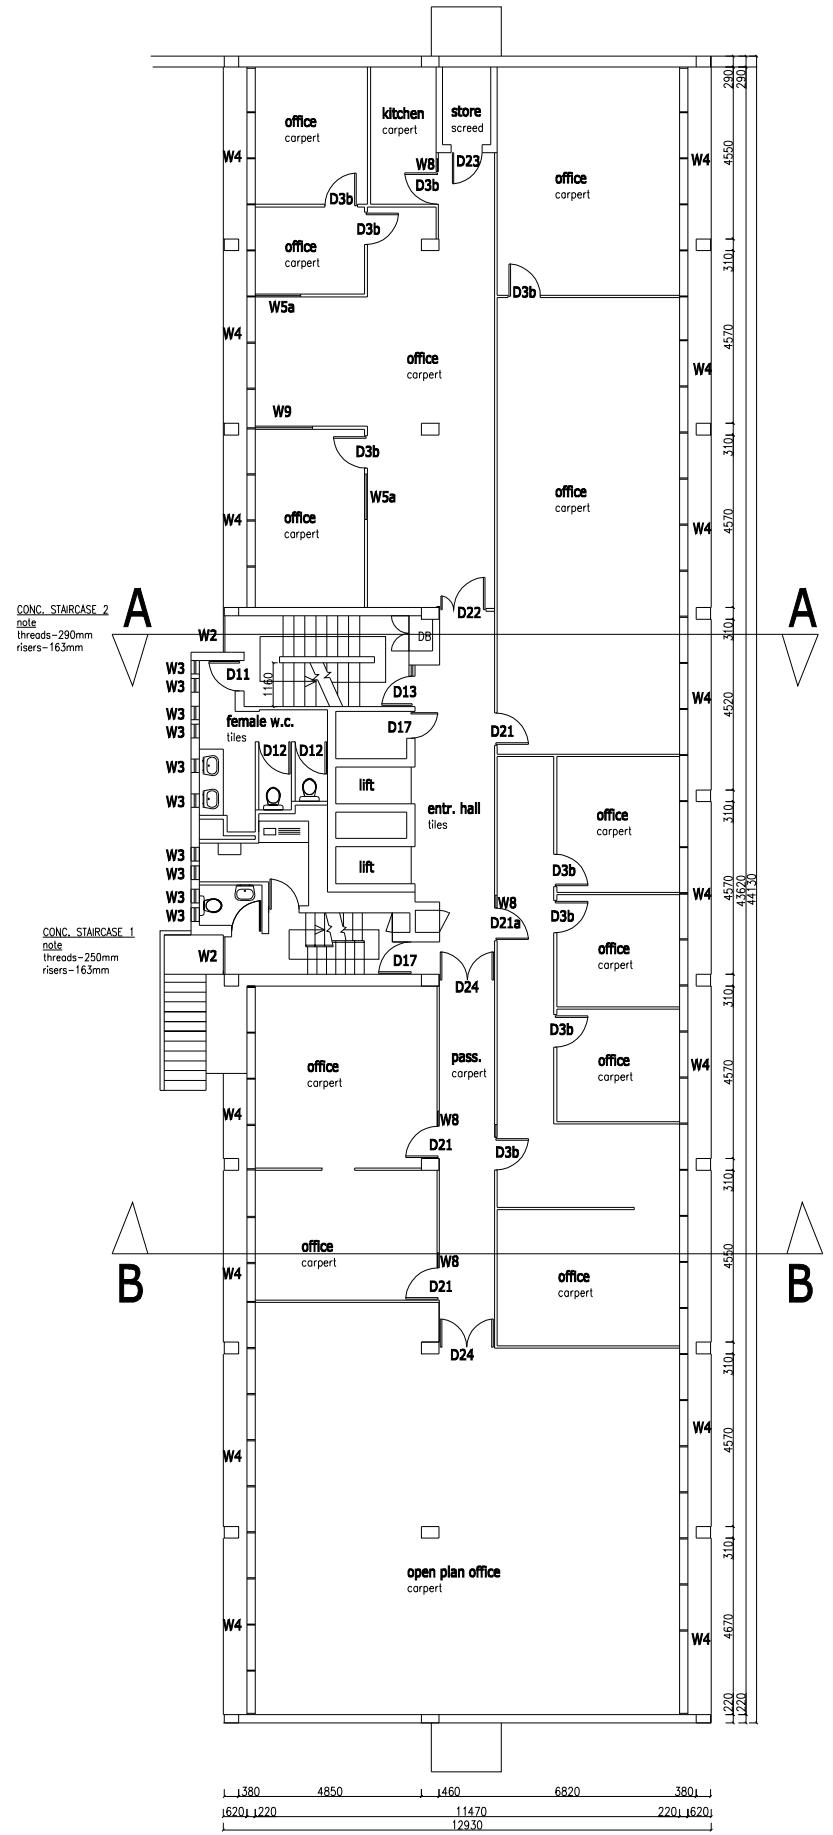

4th floor plan


SCALE 1:200




CHARTER HOUSE: Upgrade of Office Block
 15 Brand Road, Bulwer, Durban, KZN

Dwg. ref.	Building ref.	Sheet Number	REV
AB	As-built	3 of 7	0

REVISION:
 REV 0: 31/07/13
 0.1 - Submitted to client

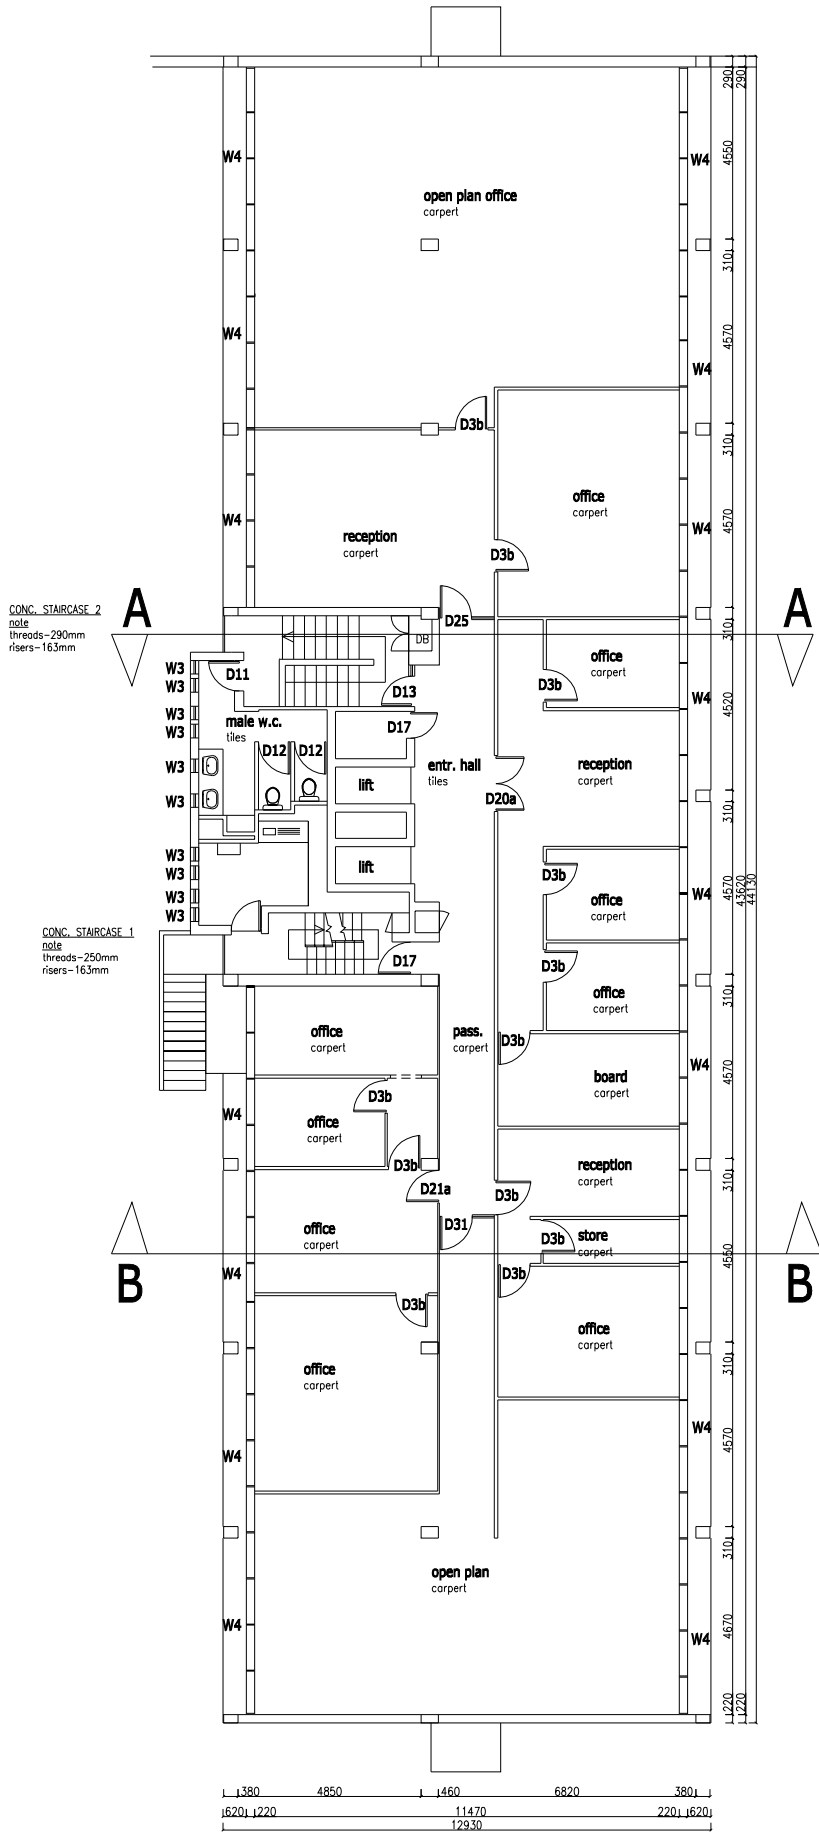

5th floor plan

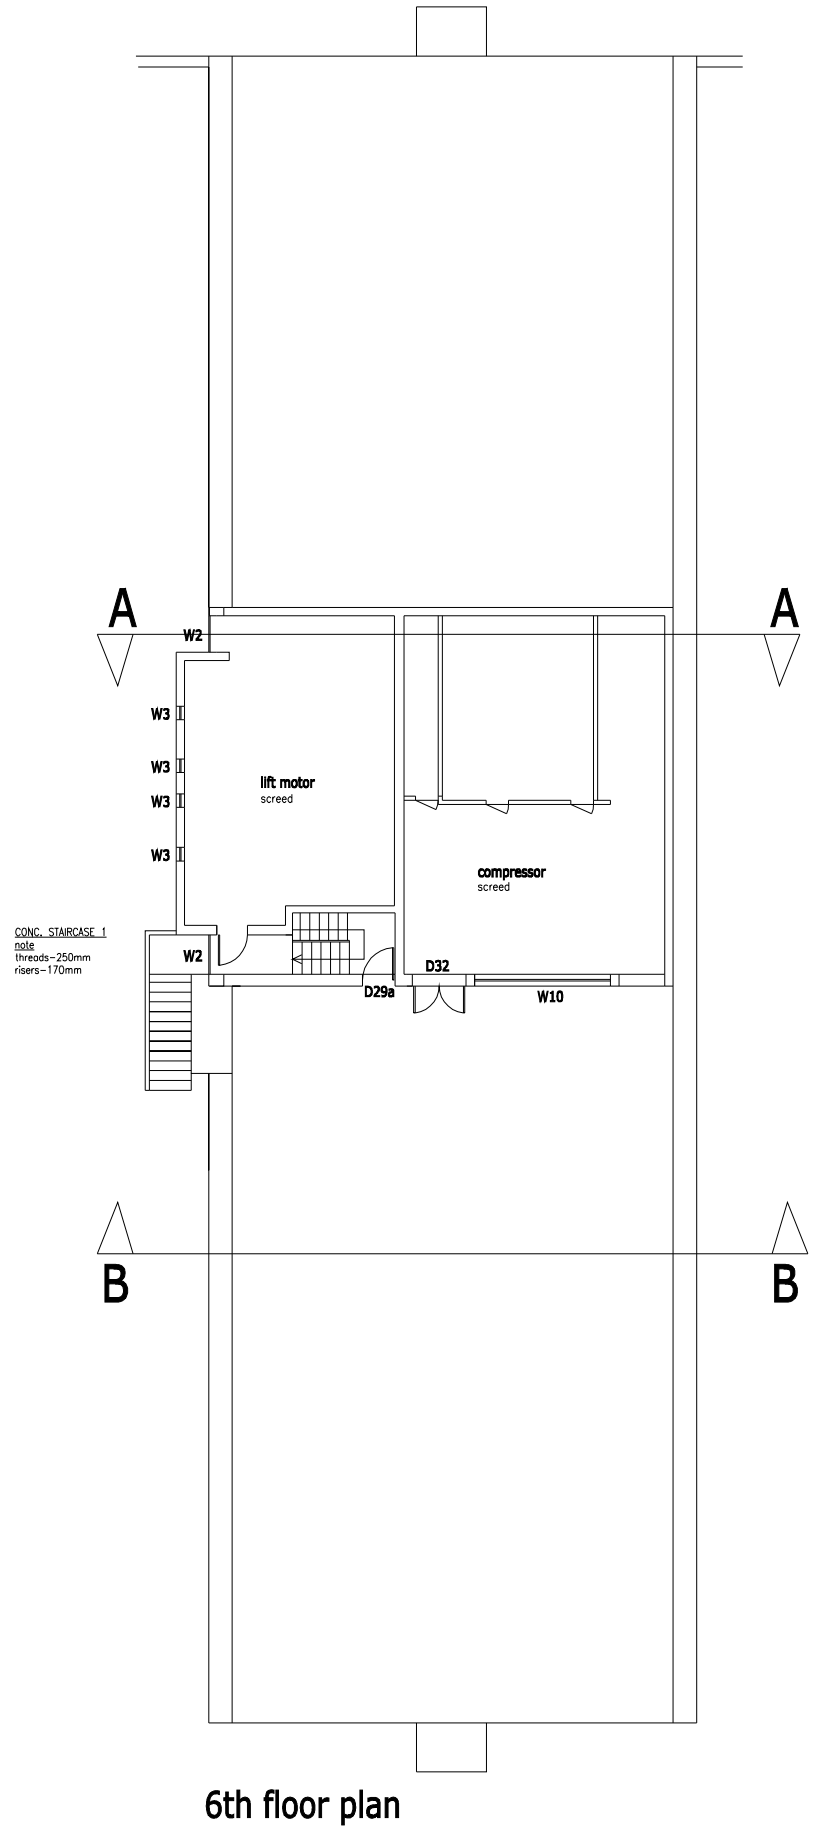

6th floor plan



SCALE 1:200



CHARTER HOUSE: Upgrade of Office Block
 15 Brand Road, Bulwer, Durban, KZN

Dwg. ref.	Building ref.	Sheet Number	REV
AB	As-built	7 of 7	0

REVISION:
 REV 0: 31/07/13
 0.1 - Submitted to client

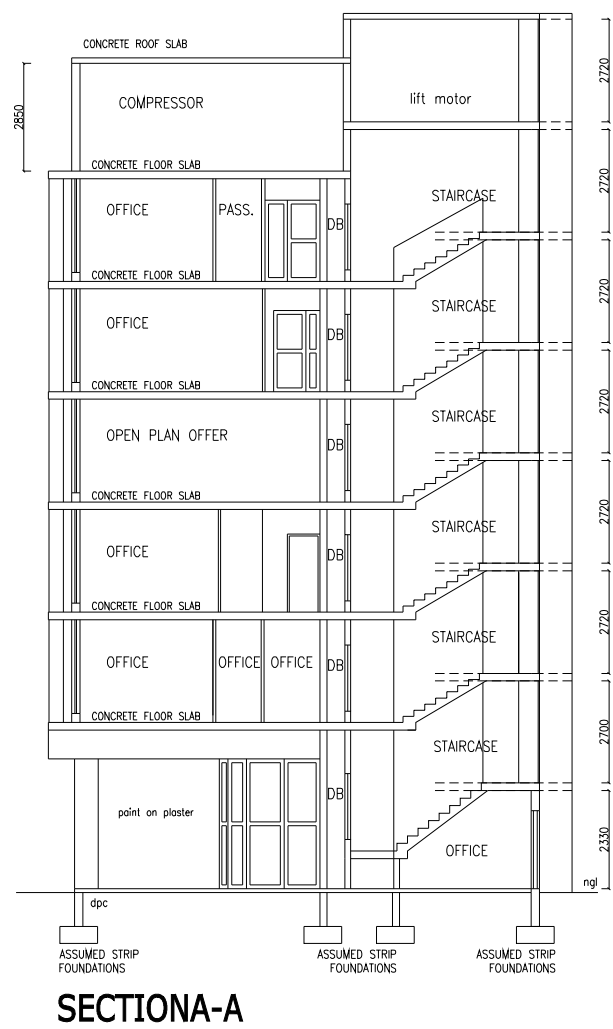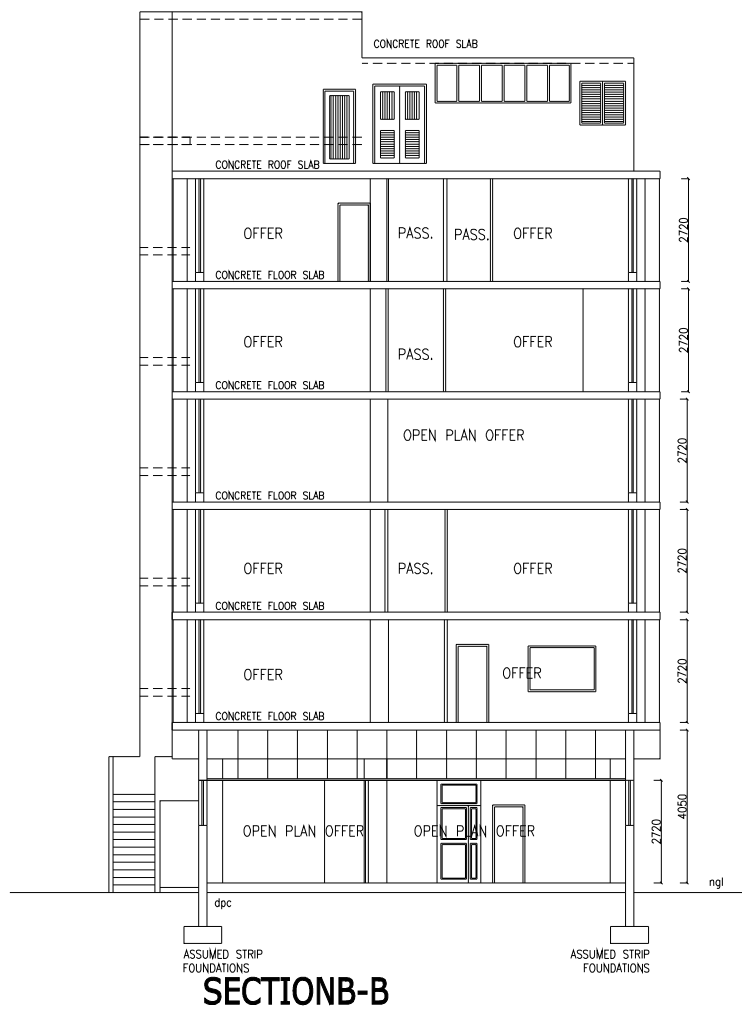


SCALE 1:200




CHARTER HOUSE: Upgrade of Office Block

Dwg. ref.	Building ref.	Sheet Number	REV
AB	As-built	5 of 7	0

REVISION:
 REV 0: 31/07/13
 0.1 - Submitted to client

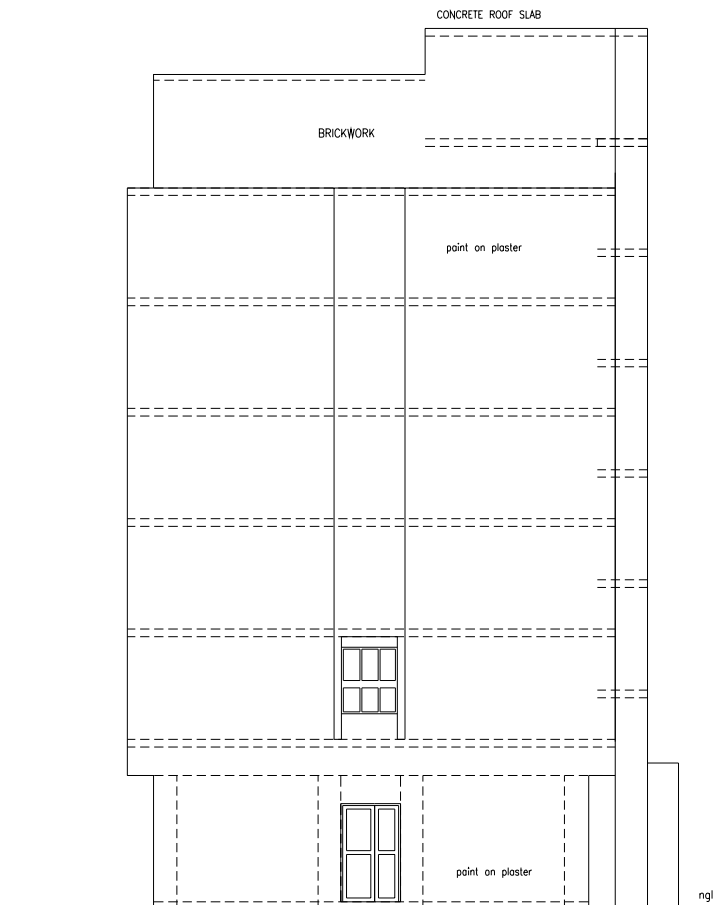

west elevation

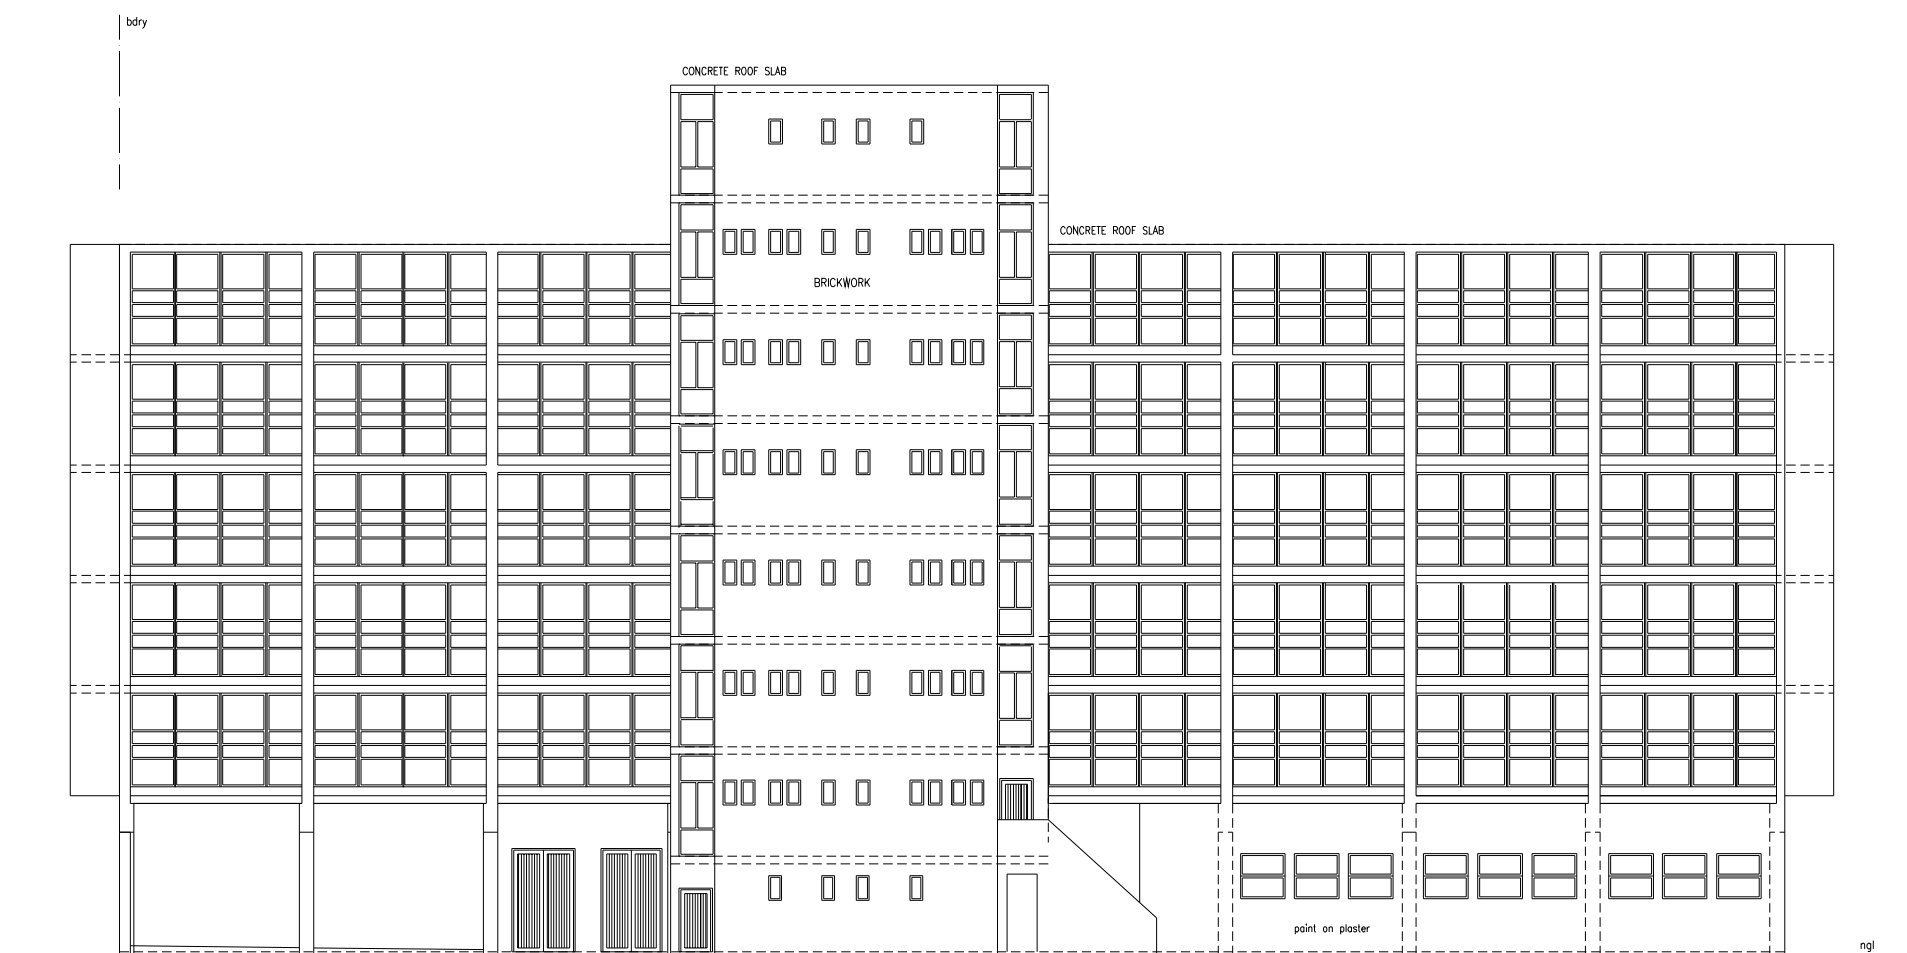

south elevation


SCALE 1:200




CHARTER HOUSE: Upgrade of Office Block

Dwg. ref.	Building ref.	Sheet Number	REV
AB	As-built	6 of 7	0

REVISION:
 REV 0: 31/07/13
 0.1 - Submitted to client

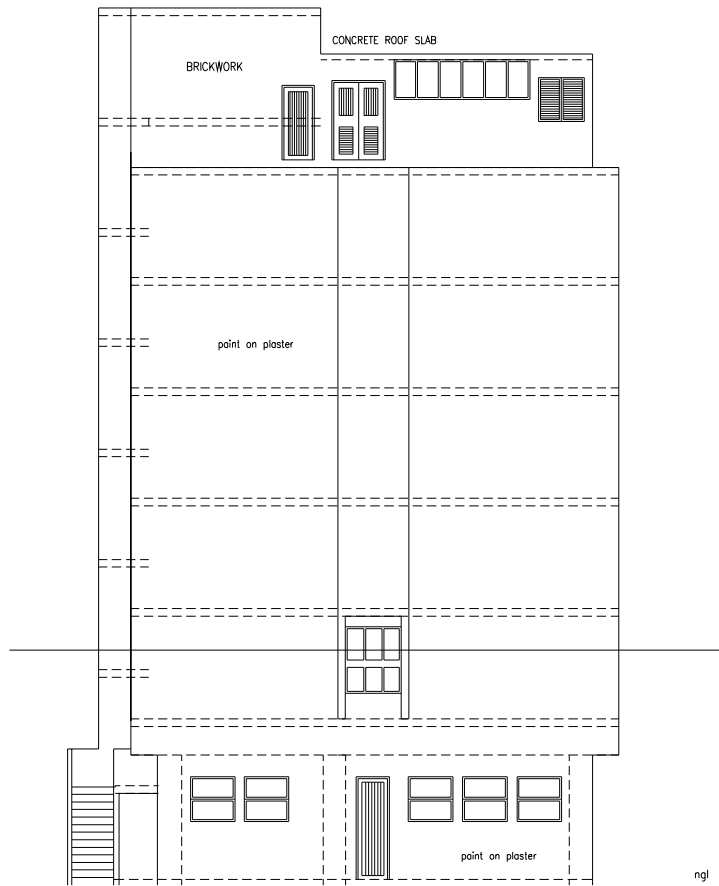

east elevation

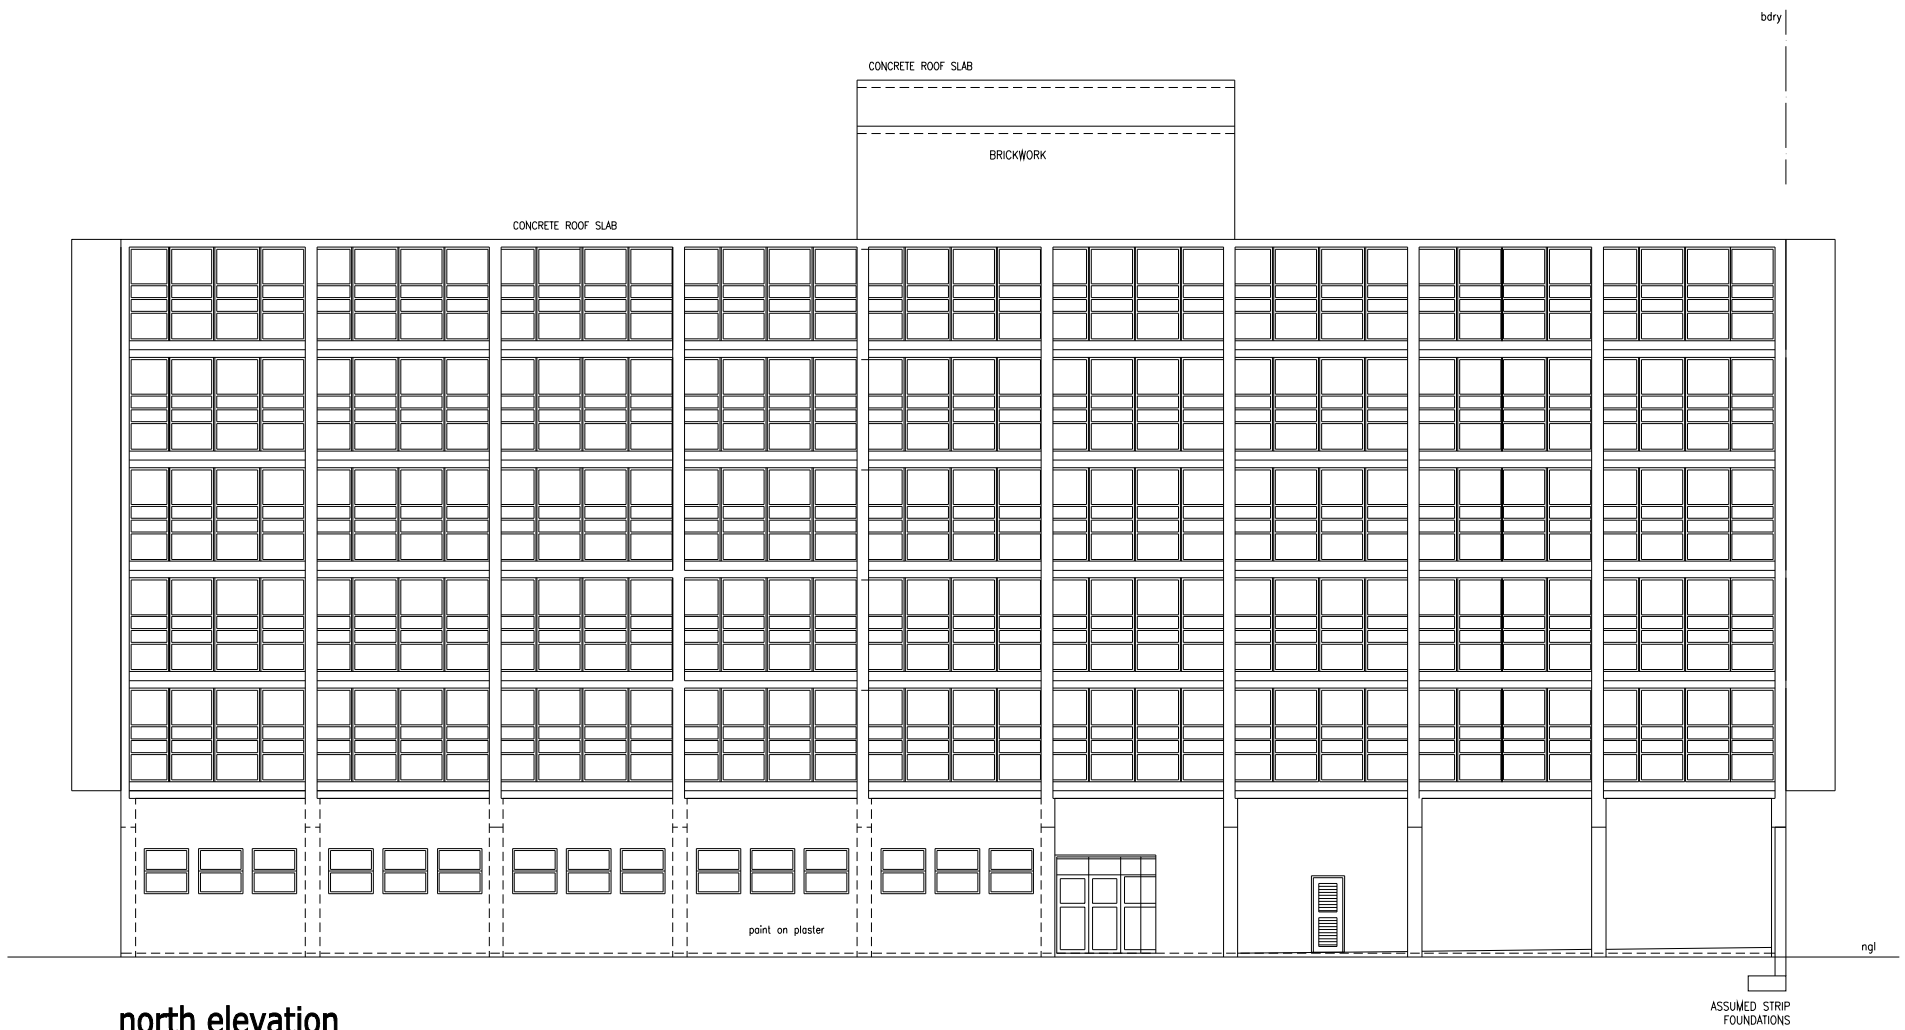

north elevation

SCALE 1:200



CHARTER HOUSE: Upgrade of Office Block

Dwg. ref.	Building ref.	Sheet Number	REV
AB	As-built	7 of 7	0